


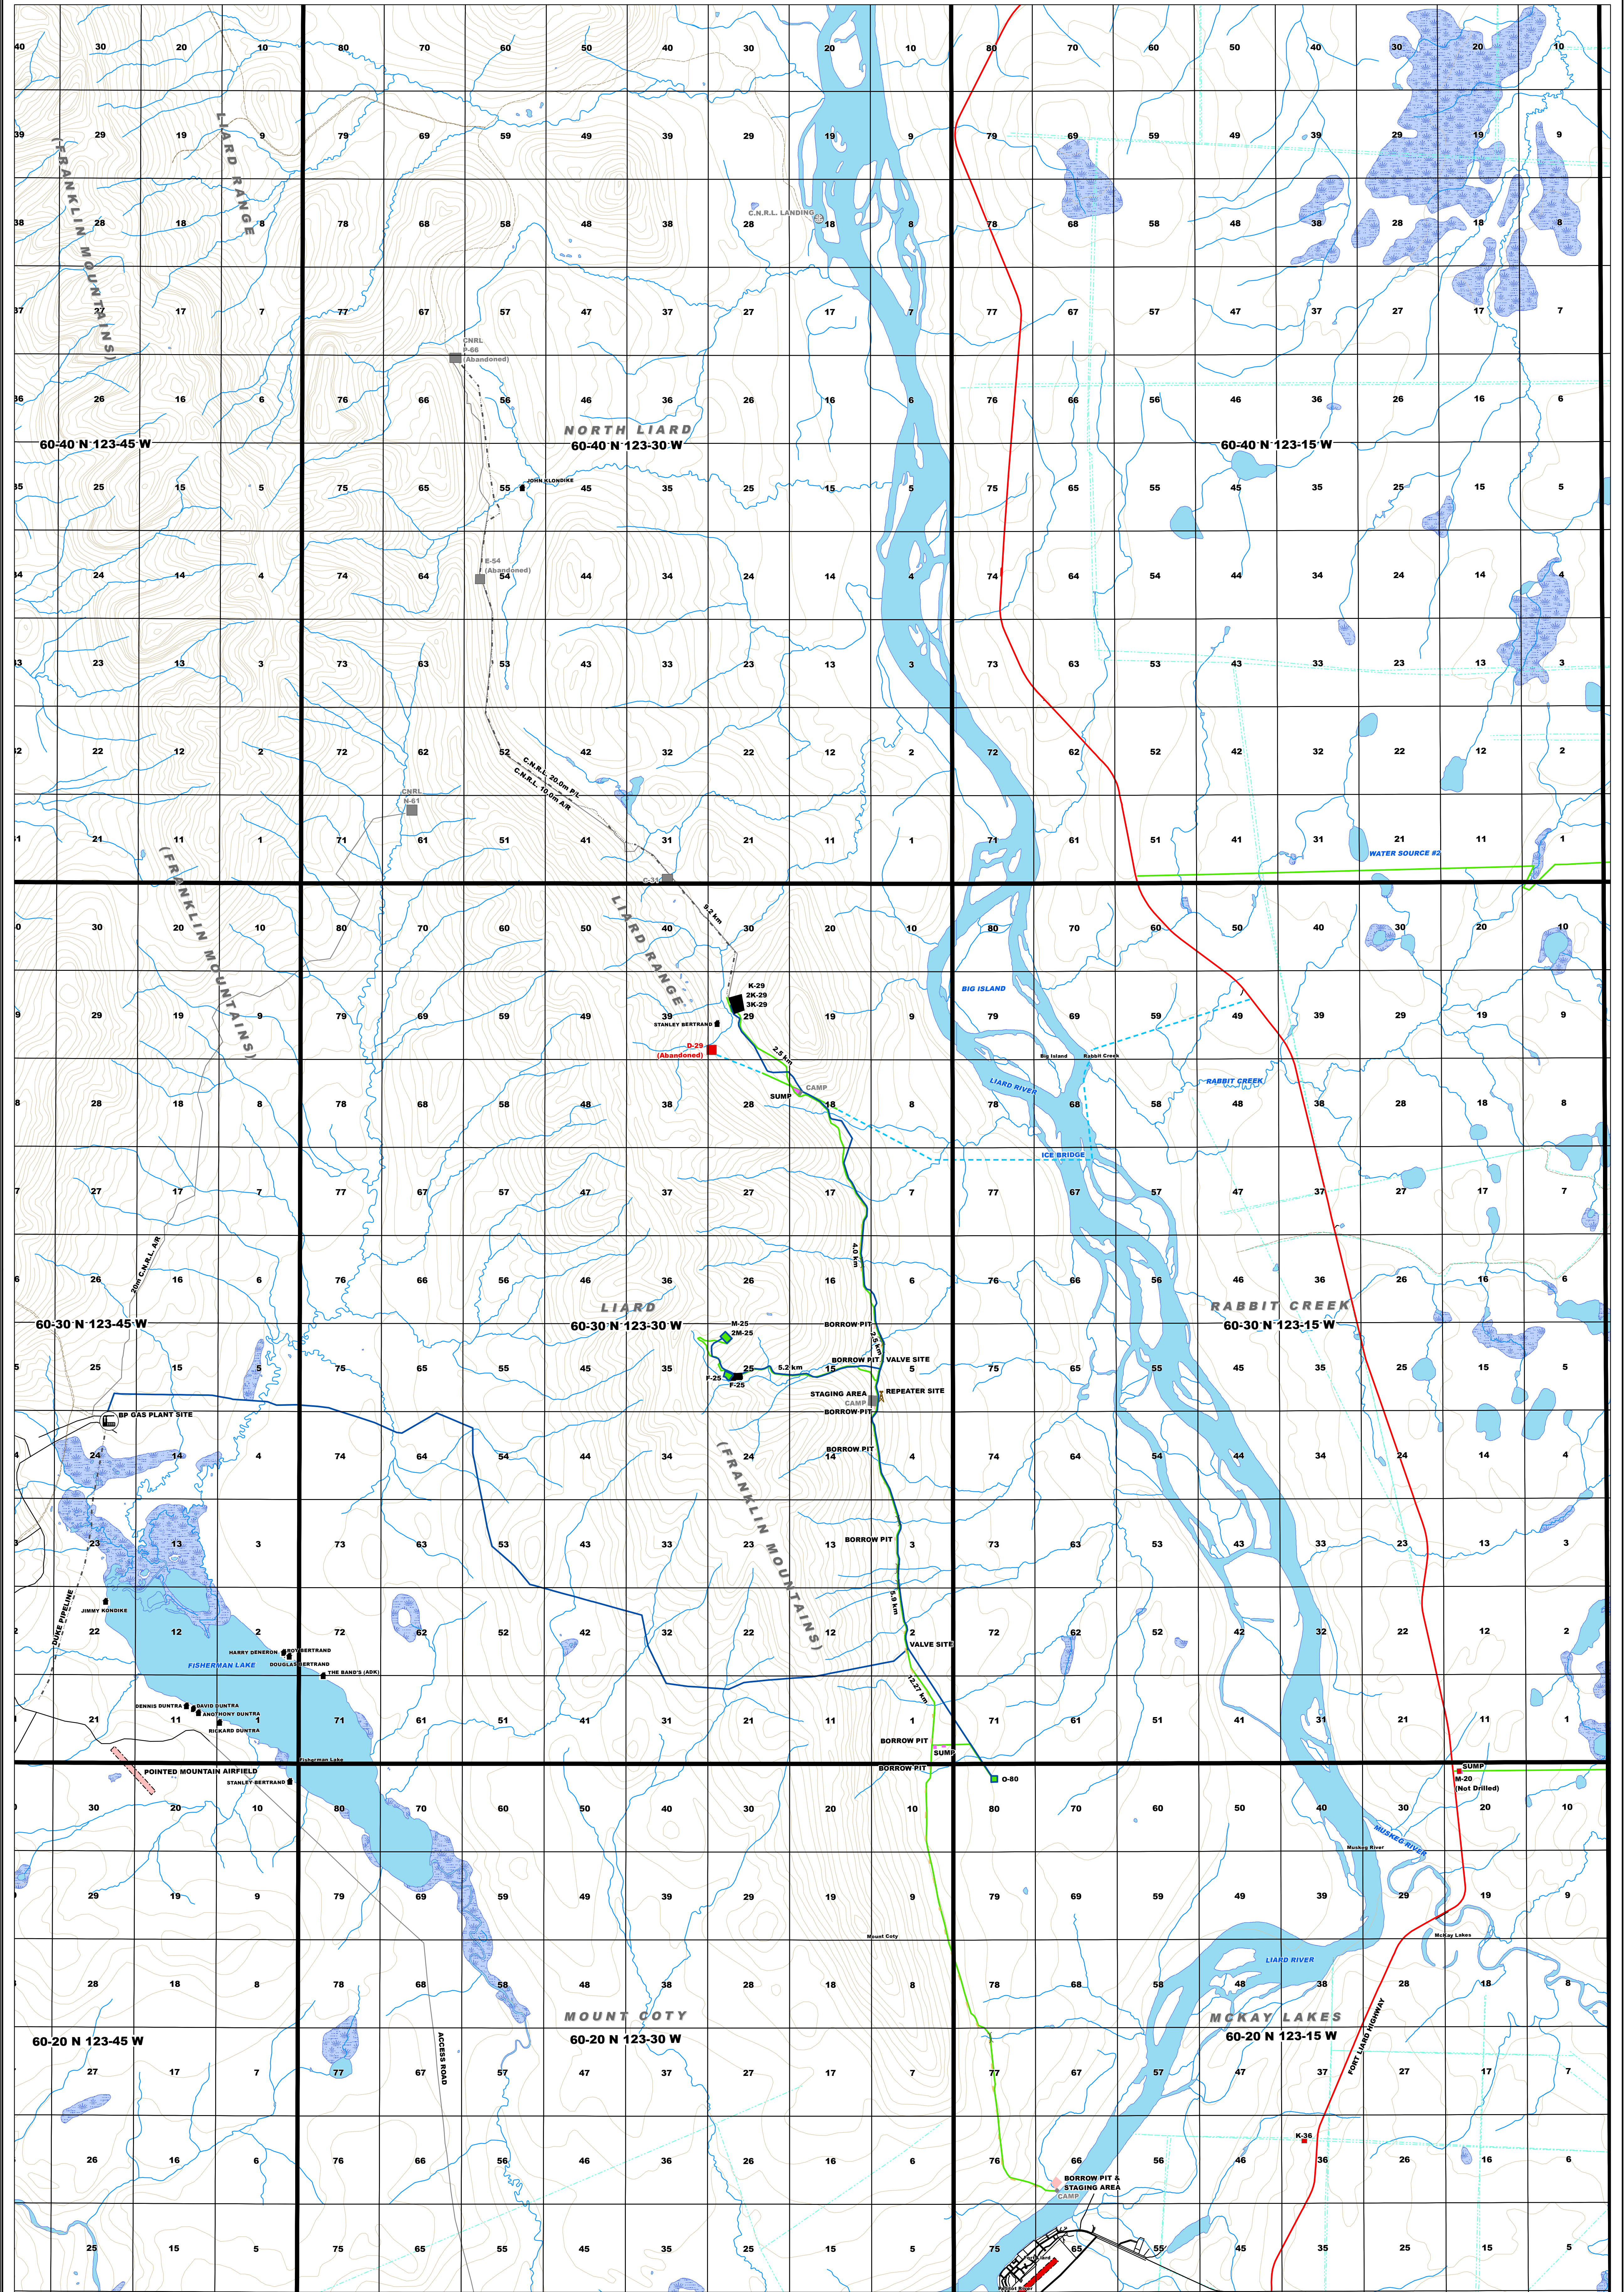

As-Built Map
FORT LIARD WEST
2013
Northwest Territories
NAD 1983 UTM Zone 10N

Legend

Cabins	Transportation	Leases	Battery	Watercourse
Seismic	Fort Liard Highway	Built	Built	String Bog
Airstrip	Old Paramout Ice Road	Built - Tied-in	Built - Tied-in	Waterbody
Built	Road	Foreign	Reclaimed	Wetland
Foreign	Trail	Gas Plant	Borrow Pit	Contours
Gathering System	Access Built	Camp	Other	
Built	Access Foreign	Built	Foreign	
Not Used	Bridge	Decking Site - Built		
Not Built	Barge			
Foreign				

Overview Map
SCALE 1:1,250,000

Scale
0 0.5 1 2 3 4 5 6 7
Kilometers

North Arrow

Tech: snicholson
Revised: 20 Aug 2013
Job No.: 05-0399G
Filename: Fort Liard_West.mxd
Projection: NAD 1983 UTM Zone 10N