

October 11, 2022

Affected Party	Contact Person(s)	Contact Information
Acho Dene Koe First Nation	Chief and Council	General Delivery, Fort Liard, NT X0G 0A0 867-770-4571 chief@adkfirstnation.ca
Acho Dene Koe First Nation Land Services c/o Shared Value Solutions	Director: Scott Mackay Manager: Meghan Buckham	62 Baker Street Guelph, Ontario N1H 4G1 226-706-888 (ext. 102 and 108) lands@adkfirstnation.ca
Acho Dene Koe Corporate Group	Tom Wezelman	General Delivery, Fort Liard, NT X0G 0A0 867-770-4571 TomWezelman@adkcorporate.ca
ADK Holdings Ltd.	Jodi Carlow	General Delivery, Fort Liard, NT X0G 0A0 (250) 727-5903 JCarlow@jbts.ca
Dehcho First Nations	Grand Chief Herb Norwegian and Resources Management Coordinator Ramona Pearson	PO BOX 89 Fort Simpson, NT X0E 0N0 867-695-2355 ramona@pearson@dehcho.org

Dene Tha First Nation	Fred Didzena Director of Lands Department	PO Box 120 Chateh, AB T0H 0S0 780-321-3774 Fred.Didzena@denetha.ca
Hamlet of Fort Liard	Mayor Genevieve McLeod and Senior Administrative Officer John McKee	General Delivery Fort Liard, NT X0G 0A0 867-770-4104 mayor@fortliard.com sao@fortliard.com
Sambaa K'e First Nation	Chief Dolphus Jumbo	PO Box 10 Trout Lake, NT X0E 1Z0 Tel: (867) 206-2800 chief@sambaakefn.com
Sambaa K'e First Nation	Jessica Jumbo Environmental Coordinator	PO Box 10 Trout Lake, NT X0E 1Z0 Tel: (867) 206-2800 environment@sambaakefn.com
Sambaa K'e First Nation	Ruby Jumbo Executive Director	PO Box 10 Trout Lake, NT X0E 1Z0 Tel: (867) 206-2800 manager@sambaakefn.com
Sambaa K'e First Nation (Planit North Inc.)	Christine Wenman Lands, Resources and Environment Advisor	1st Floor, 4501 – 50th Avenue Yellowknife, NT Tel: (867) 445-4127 christine@planitnorth.ca
Sambaa K'e Development Corporation	Brenda Jumbo Manager	PO Box 10 Trout Lake, NT X0E 1Z0 Tel: (867) 206-2800 sdcorp@yahoo.ca

Dear Sir or Madam,

RE: Liard East Winter of 2022-2023 Activity under MV2020L1-0007 and MV2020A0010


Paramount Resources Ltd. ("Paramount") is proposing to conduct abandonment activities at Liard East this winter which is regulated by the Office of Regulator of Oil and Gas Operations ("OROGO"). Additionally, Paramount may undertake other closure activities at the same time. Activities are projected to occur between the months of December of 2022 and March of 2023. This program will go ahead if the following conditions are satisfied:

1. There is not a substantive change to the COVID situation.
2. Paramount is able to procure the necessary services.
3. Other area operators conduct their planned activities in 2020-2023.

Paramount has the necessary Land Use Permit and Water Licence along with the required OROGO authorizations to undertake the program. The Liard East program would include opening the previously used and currently permitted winter access, camp activities, abandonments and other closure activities. Paramount has been working with other area operators to execute the project and for securing services.



Enclosed with this letter are project maps for reference. If you have any questions or comments regarding the program, please contact the undersigned via email at terence.hughes@paramountres.com or via phone at 403-206-3859.

Respectfully,
Paramount Resources Ltd.

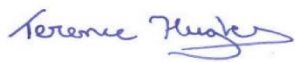A handwritten signature in blue ink that reads "Terence Hughes".


Terence Hughes
Regulatory and Community Affairs Advisor

ENCL.

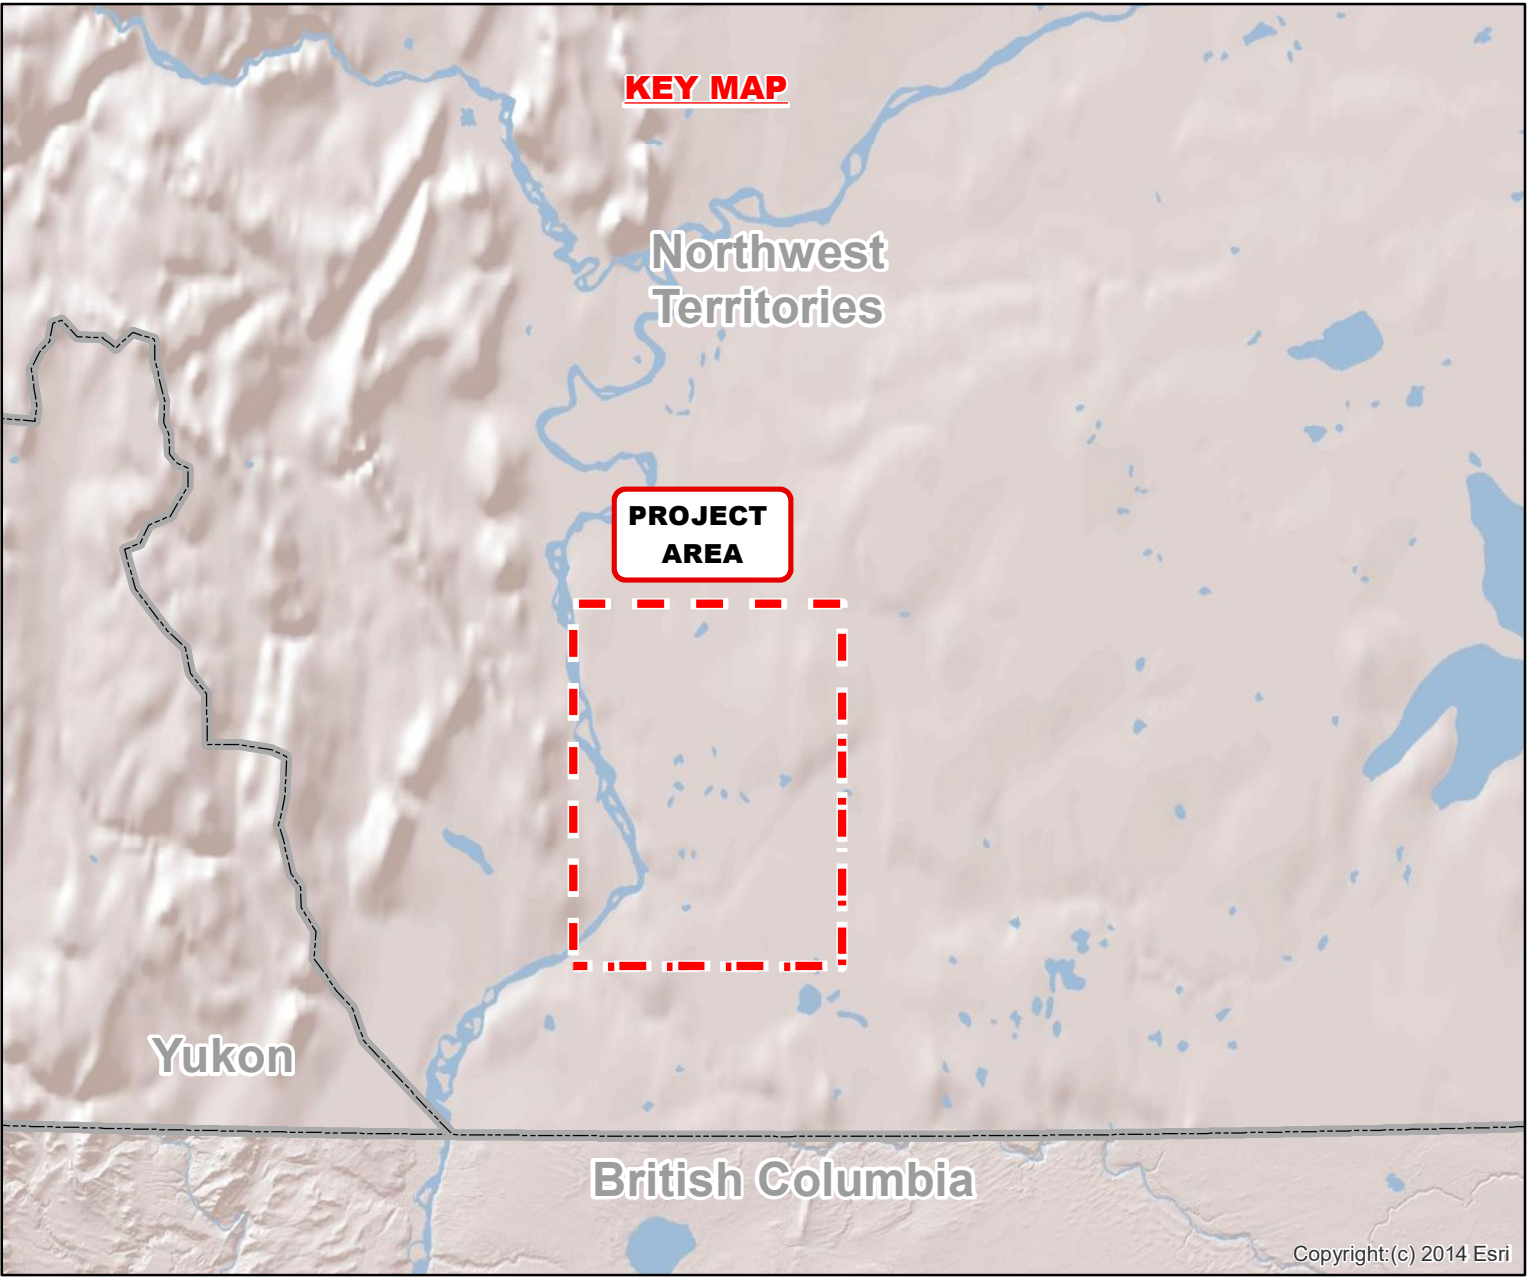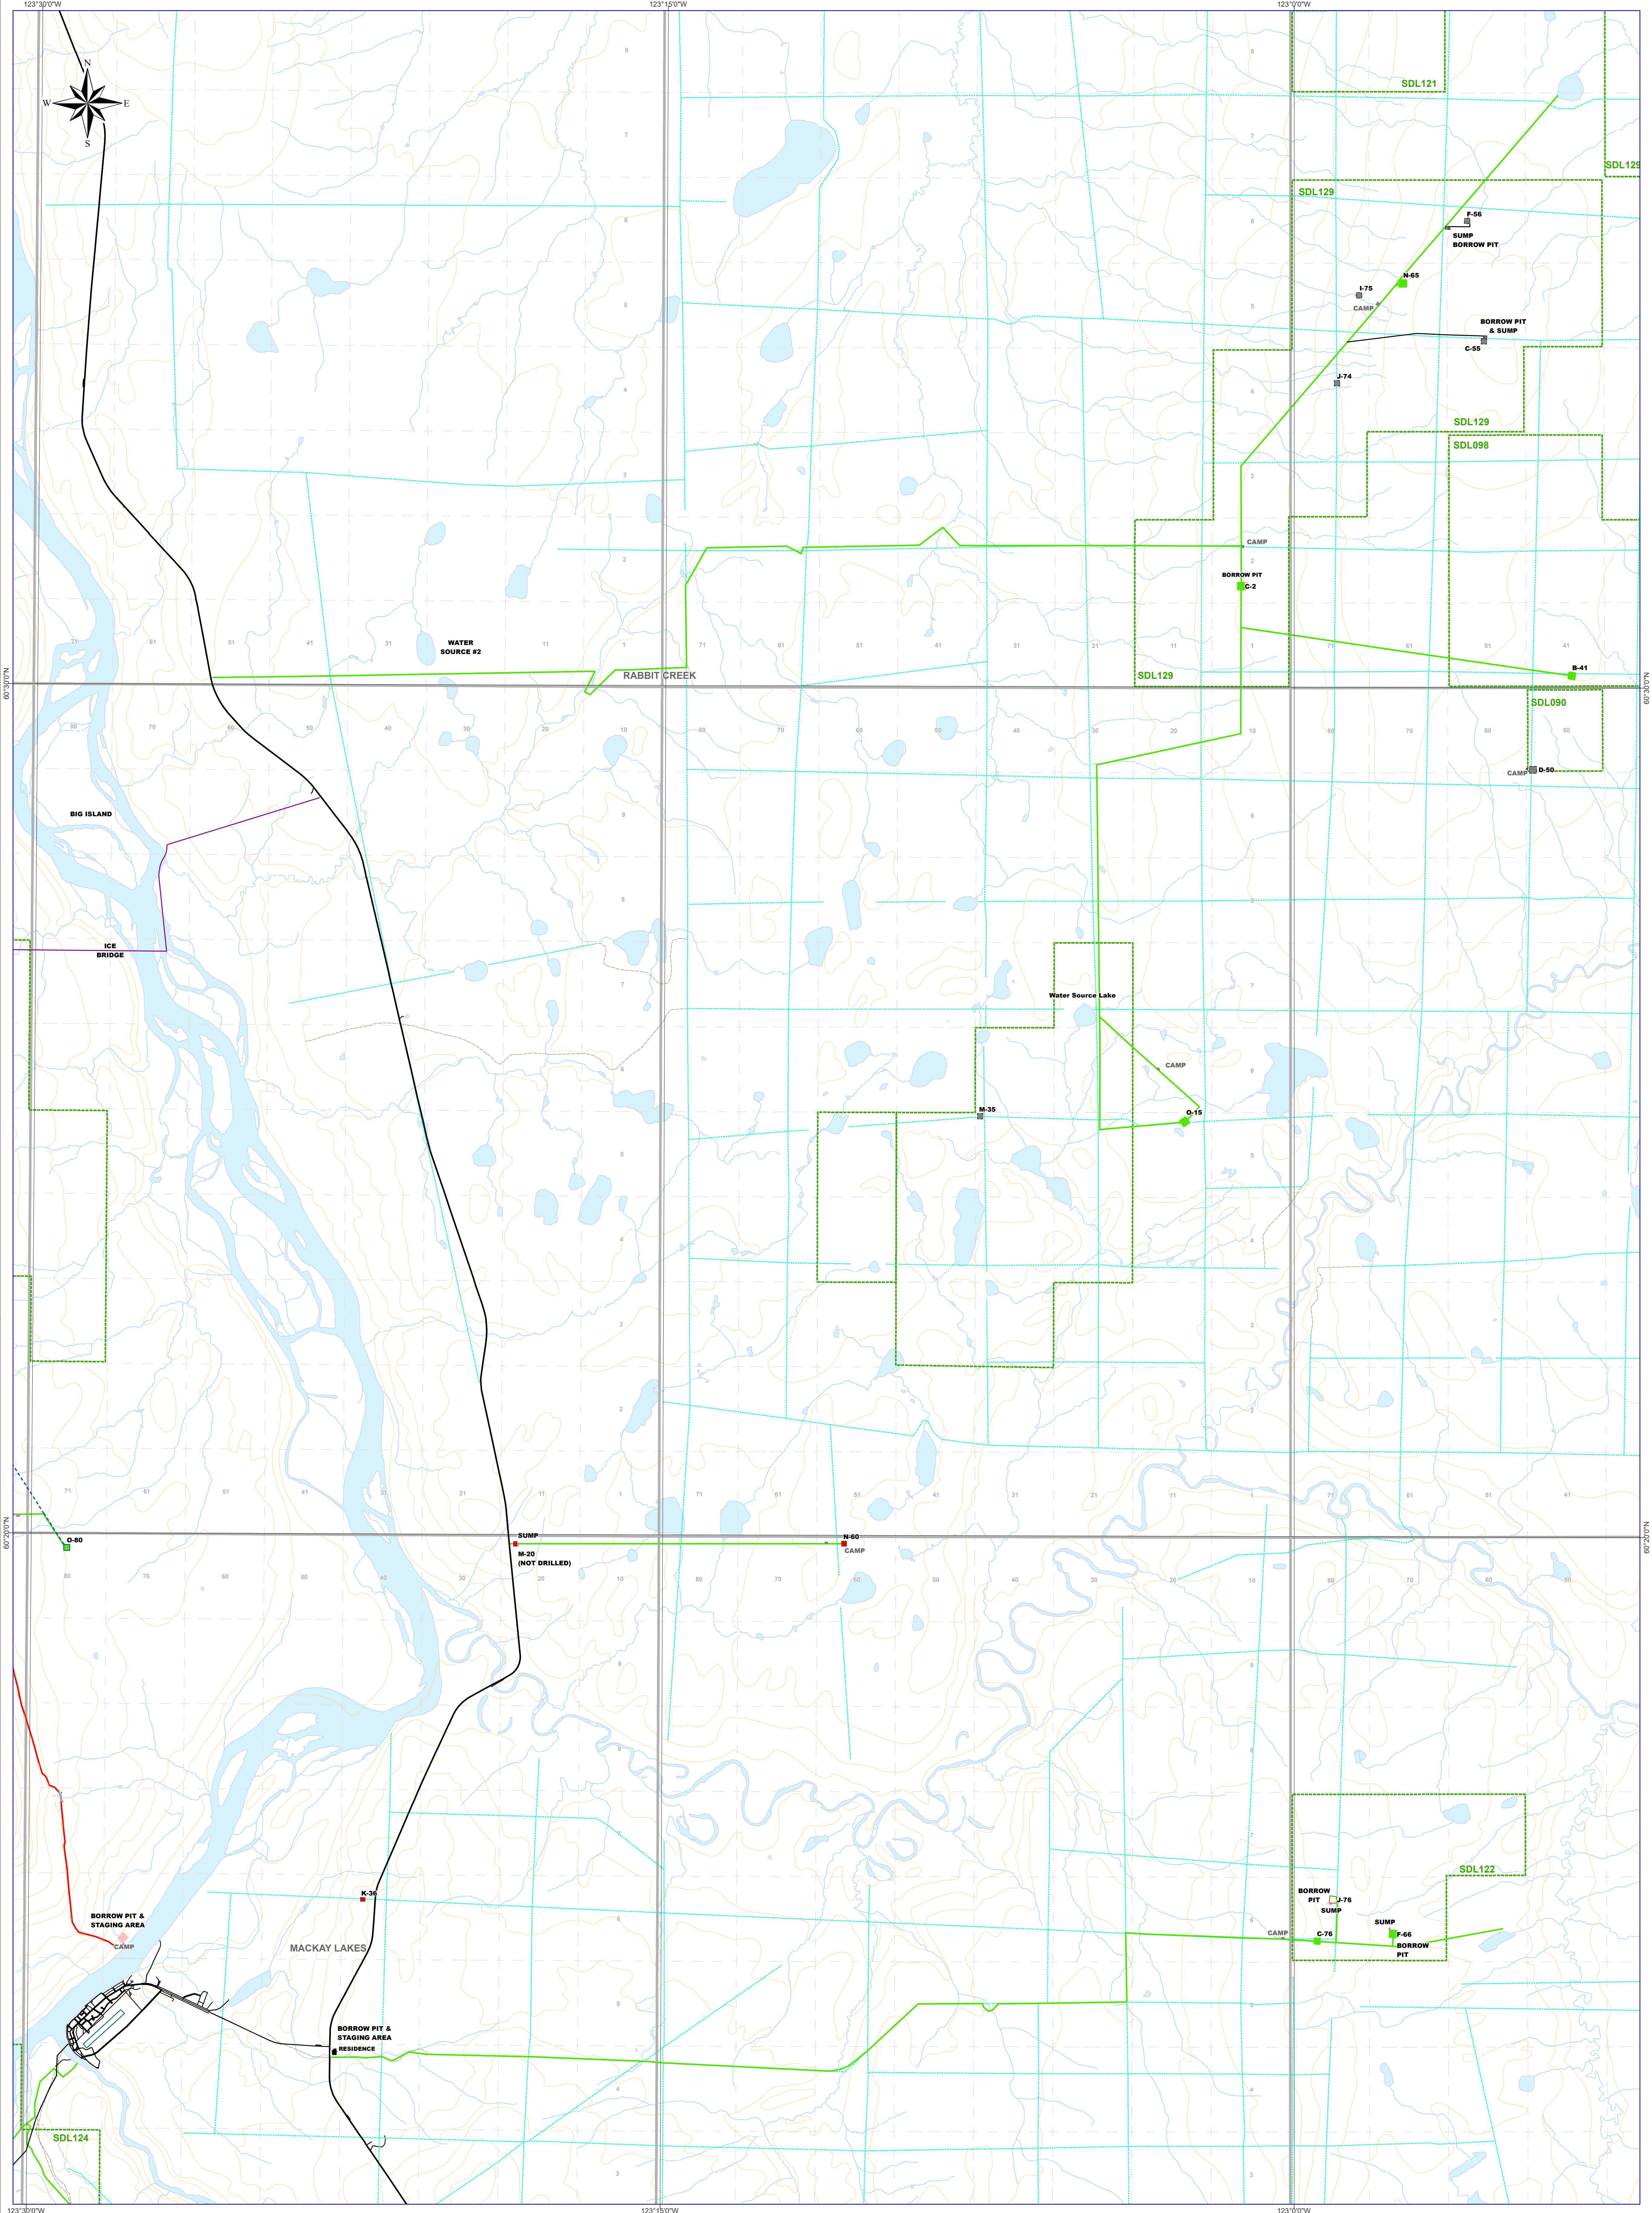

OVERVIEW MAP SHOWING
FORT LIARD EAST
As-Build June 2009

60°40', 123°15' Sec.78 to 60°20', 122°45' Sec.33
NORTHWEST TERRITORIES

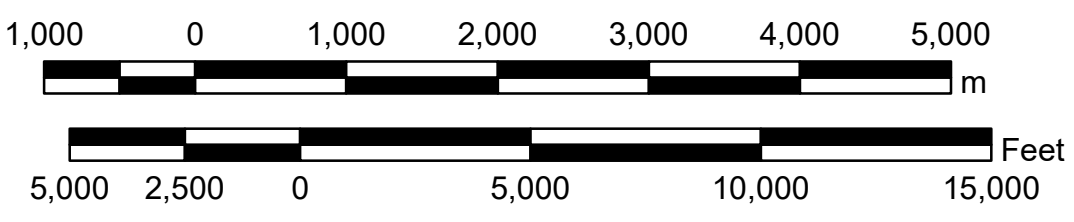



Scale: 1:50,000

- Legend**
- Seismic
 - Airstrip
 - Airstrip (Foreign)
 - Pipeline R/W
 - Pipeline R/W Foreign
 - Winter Access Road
 - All Season Access Road
 - Access Road - (Foreign)
 - Fort Liard Highway
 - Old Paramount Ice Road
 - Road
 - Trail
 - Significant Discovery Licence
 - Contour
 - Abandoned
 - Built
 - Built - Tied-in
 - Foreign
 - Reclaimed
 - Suspended
 - Bridge

DISCLAIMER:
The information contained herein is compiled from various government and industry sources. Universal Geomatics Solutions and its data suppliers provide no warranty regarding the accuracy or completeness of this information. No liability can be assumed by Universal Geomatics Solutions or its data suppliers resulting from the use or interpretation of this information, or from any decisions made based on this information.

REVISION	DESCRIPTION	DRAWN BY	DATE
00	Original Map Created as 050399G01_2009.dwg	WGT	2006-06-13
06	Updated Map Title	BPV	2009-06-03
07	Status of J-76 changed to 'Abandoned'	AJB	2020-04-01



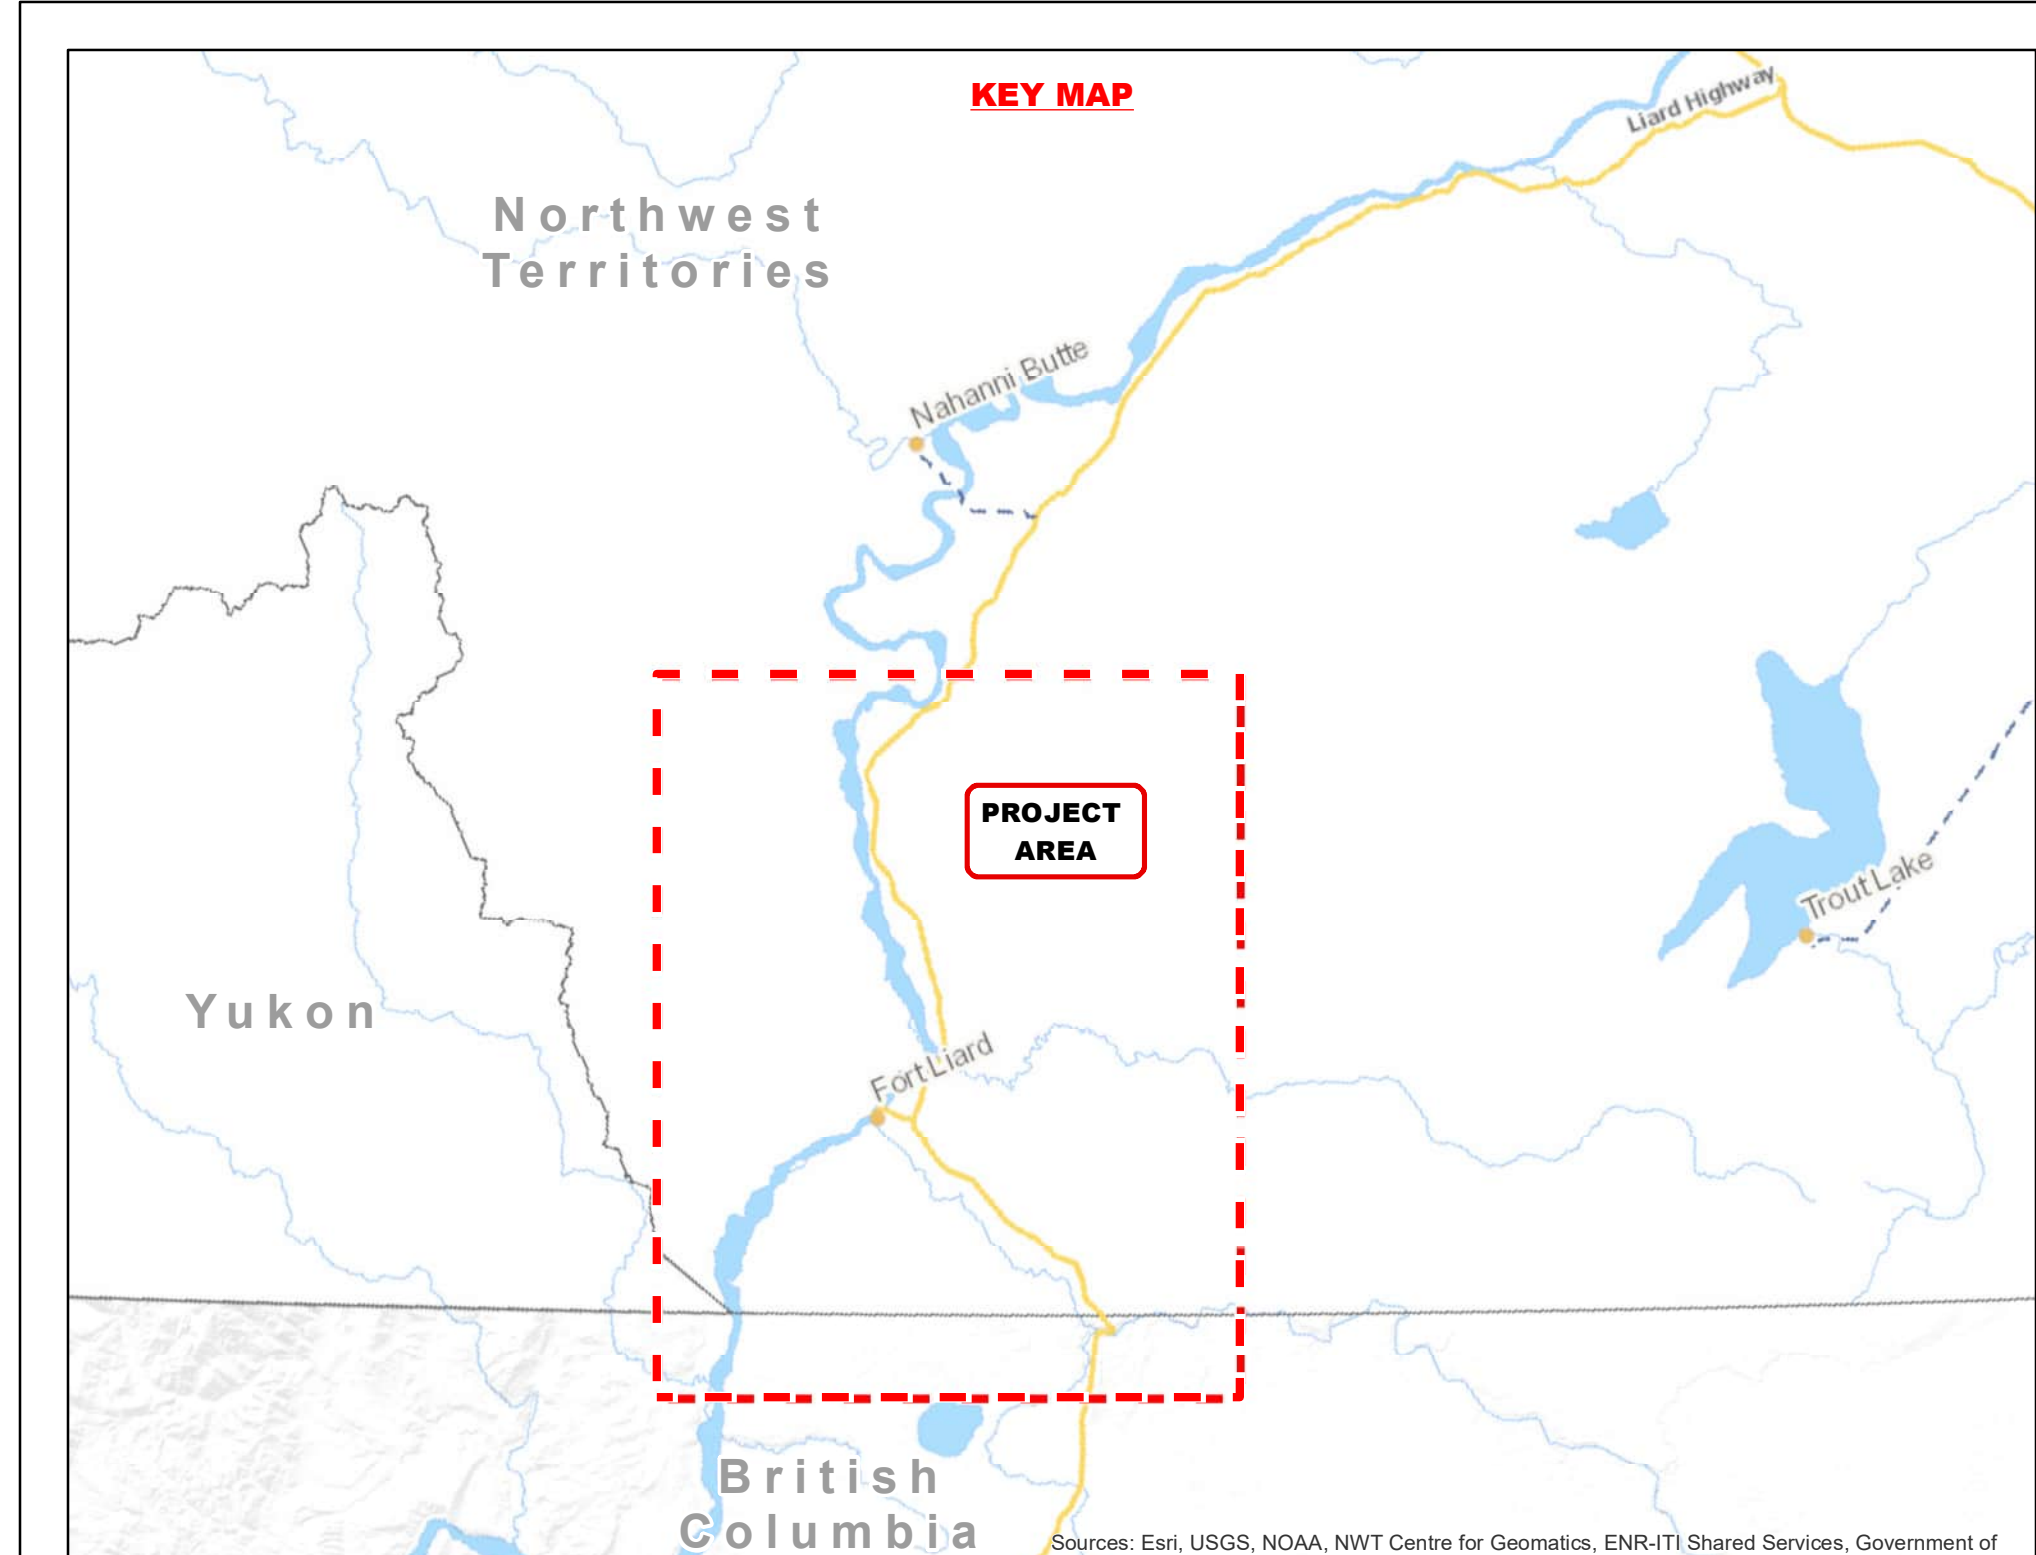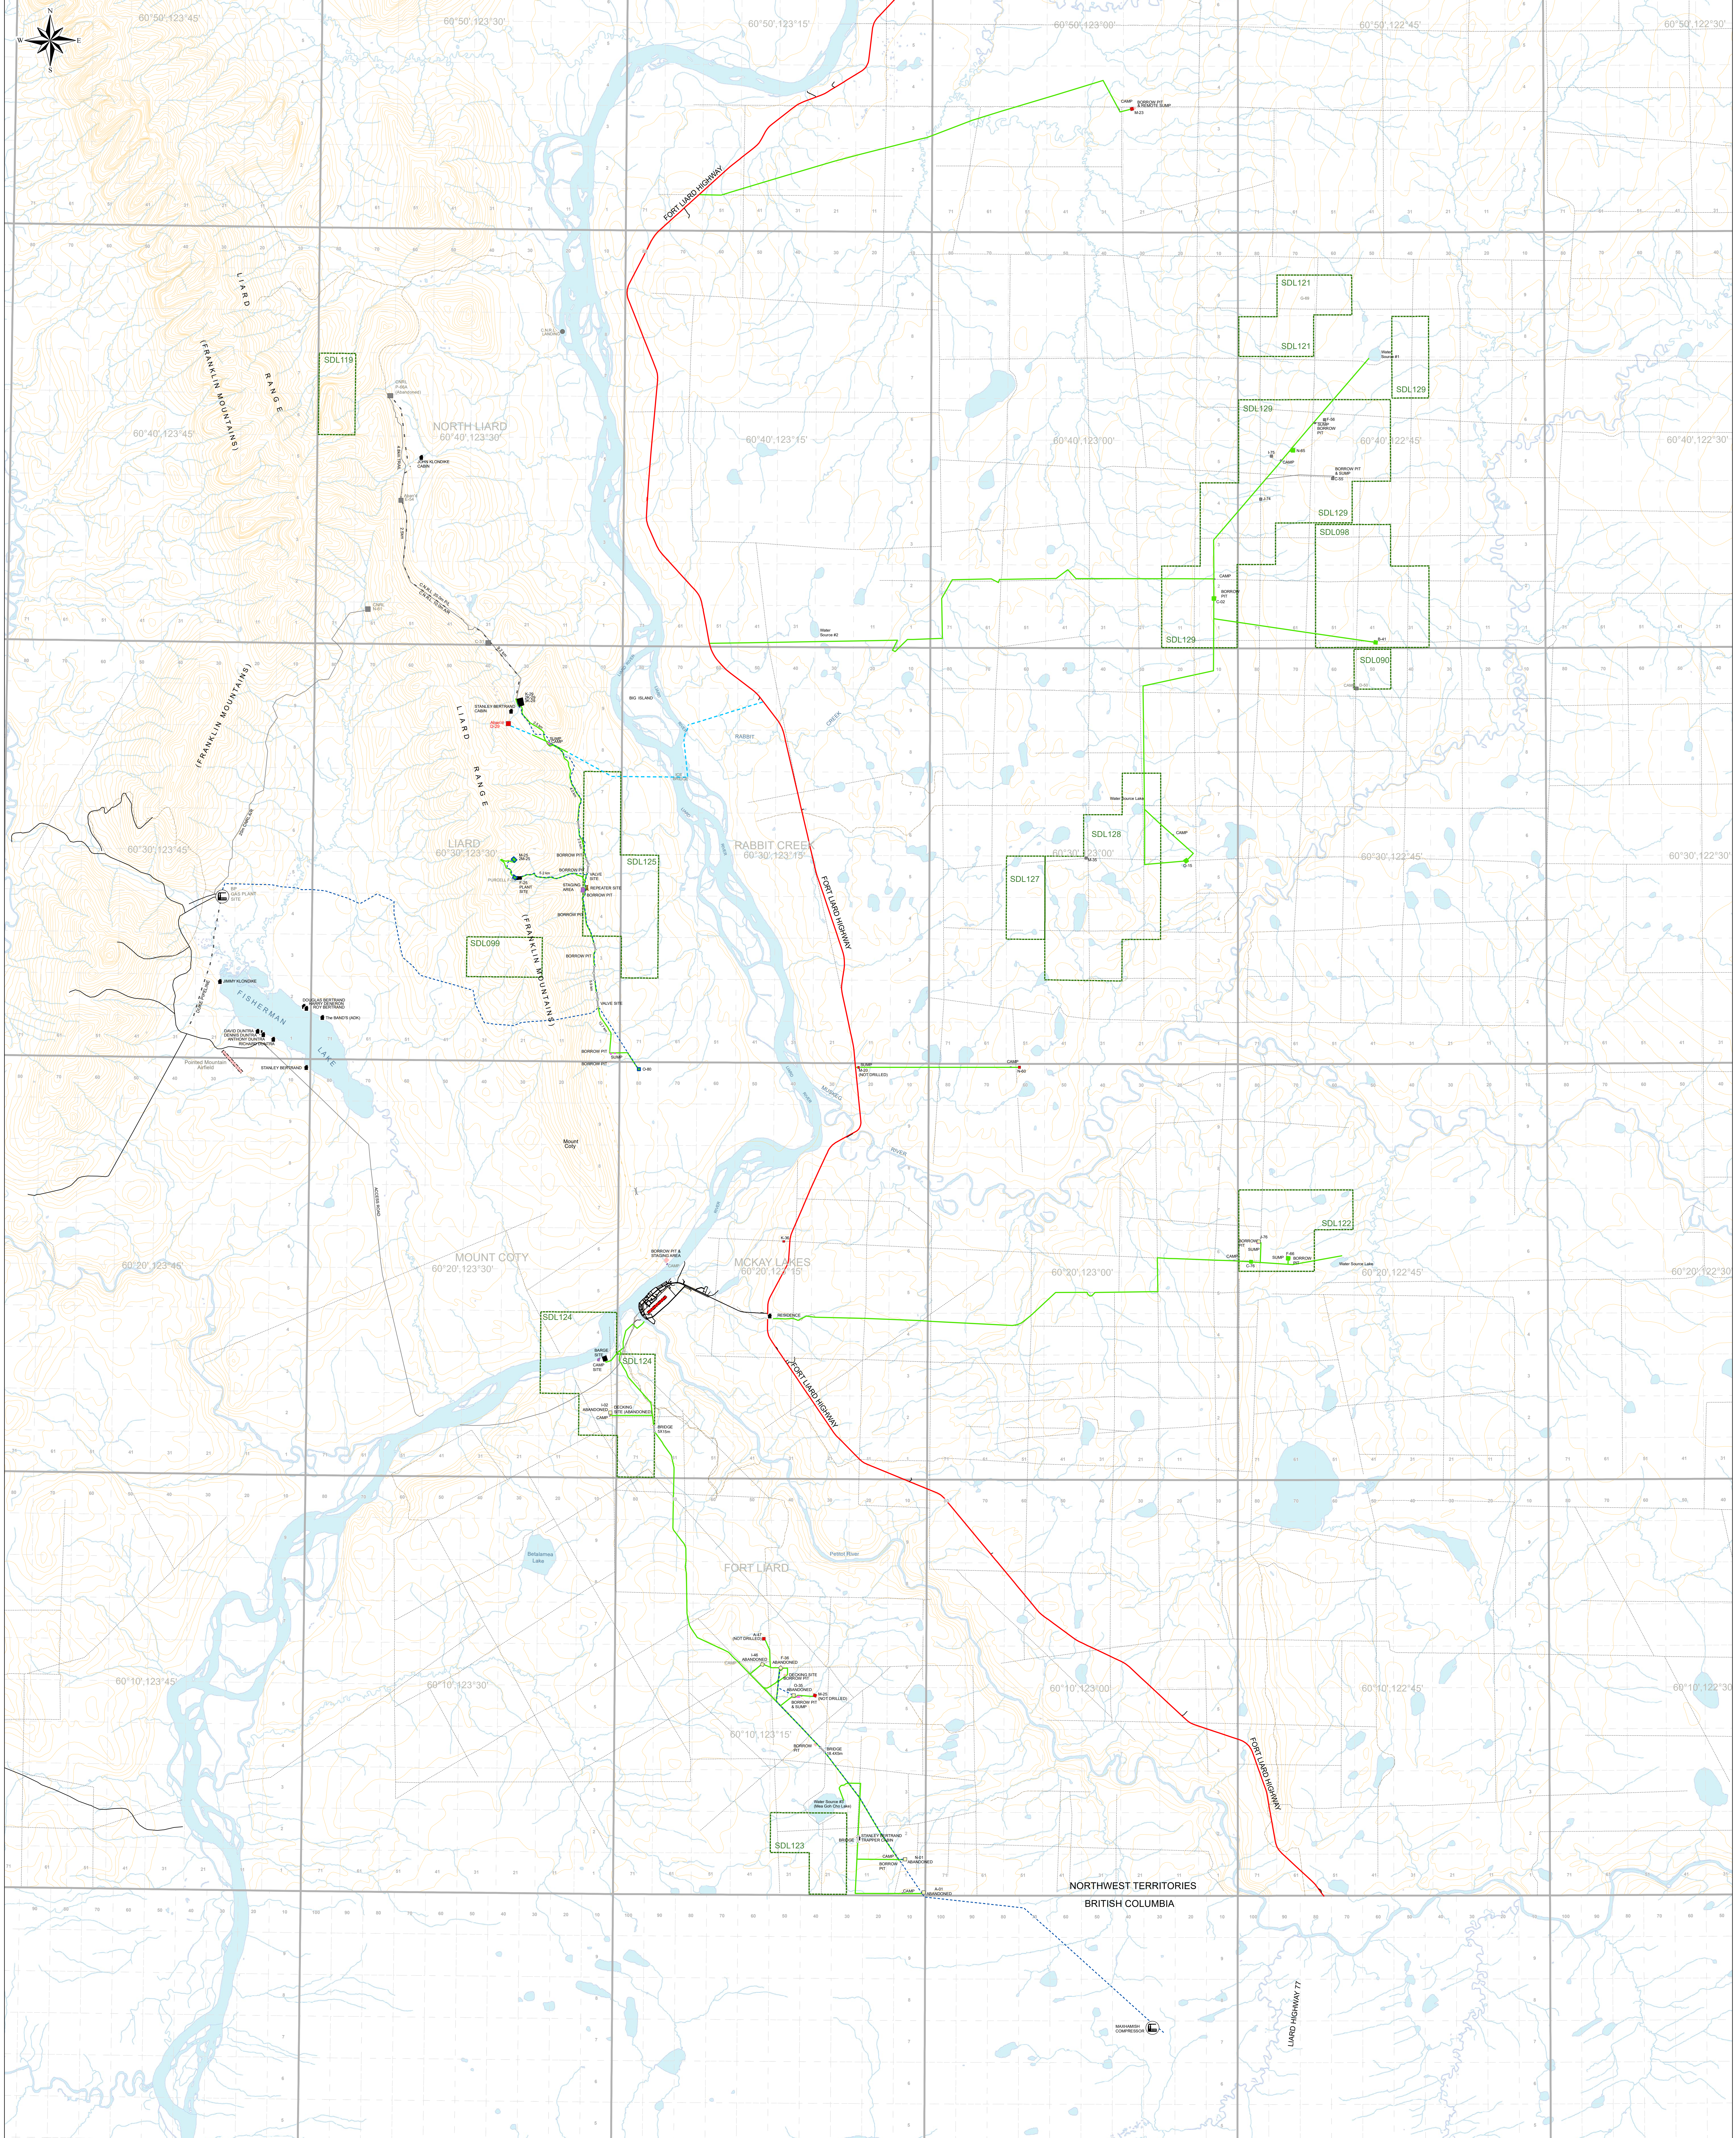




OVERVIEW MAP SHOWING

FORT LIARD

As-Built October 2022
60°50', 123°45" to 60°10", 122°45"
NORTHWEST TERRITORIES

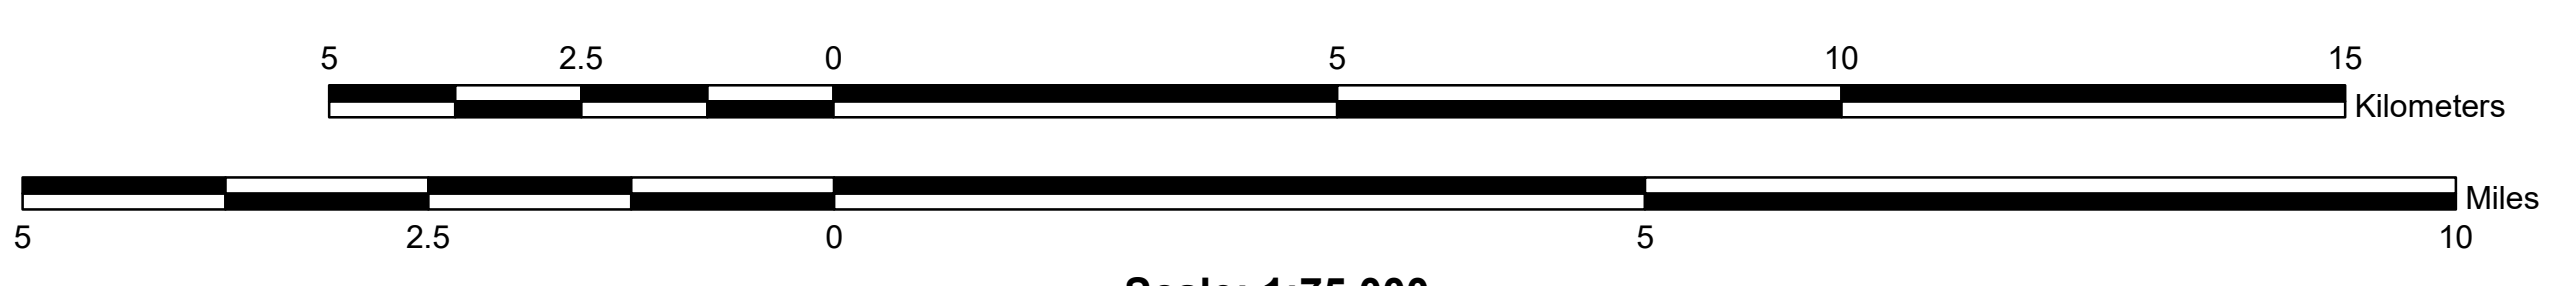

Scale: 1:75,000

Legend

Leases

- Abandoned
- Built
- Built - Tied-in
- Foreign
- Reclaimed
- Suspended

Facilities

- Camp - Built
- Camp - Foreign
- Battery - Built
- Sump - Built
- Borrow Pit - Built
- Decking Site - Built

Gathering System

- Built
- Not Used
- Not Built
- Foreign
- Suspended

Access Roads

- Access Built
- Access Foreign

Transportation

- Highway
- Old Paramount Ice Road
- Road
- Trail
- Cut Line

Boundaries

- SDL Lands
- Provincial Boundaries
- Contours

Hydrography

- Waterbody
- Watercourse

Other

- Bridge
- Gas Plant / Compressor
- Cabins

DISCLAIMER: The information contained herein is compiled from various government and industry sources. Universal Geomatics Solutions and its data suppliers provide no warranty regarding the accuracy or completeness of this information. No liability can be assumed by Universal Geomatics Solutions or its data suppliers resulting from the use or interpretation of this information, or from any decisions made based on this information.

REVISION	DESCRIPTION	DRAWN BY	DATE
01	Original Map Created as 170347-OM-01	KDG	2017-06-26
02	Status of I-02, F-36 changed to 'Abandoned'	AJB	2022-10-06



www.ugs.ca